


AS-BUILT

JUN 27 2005

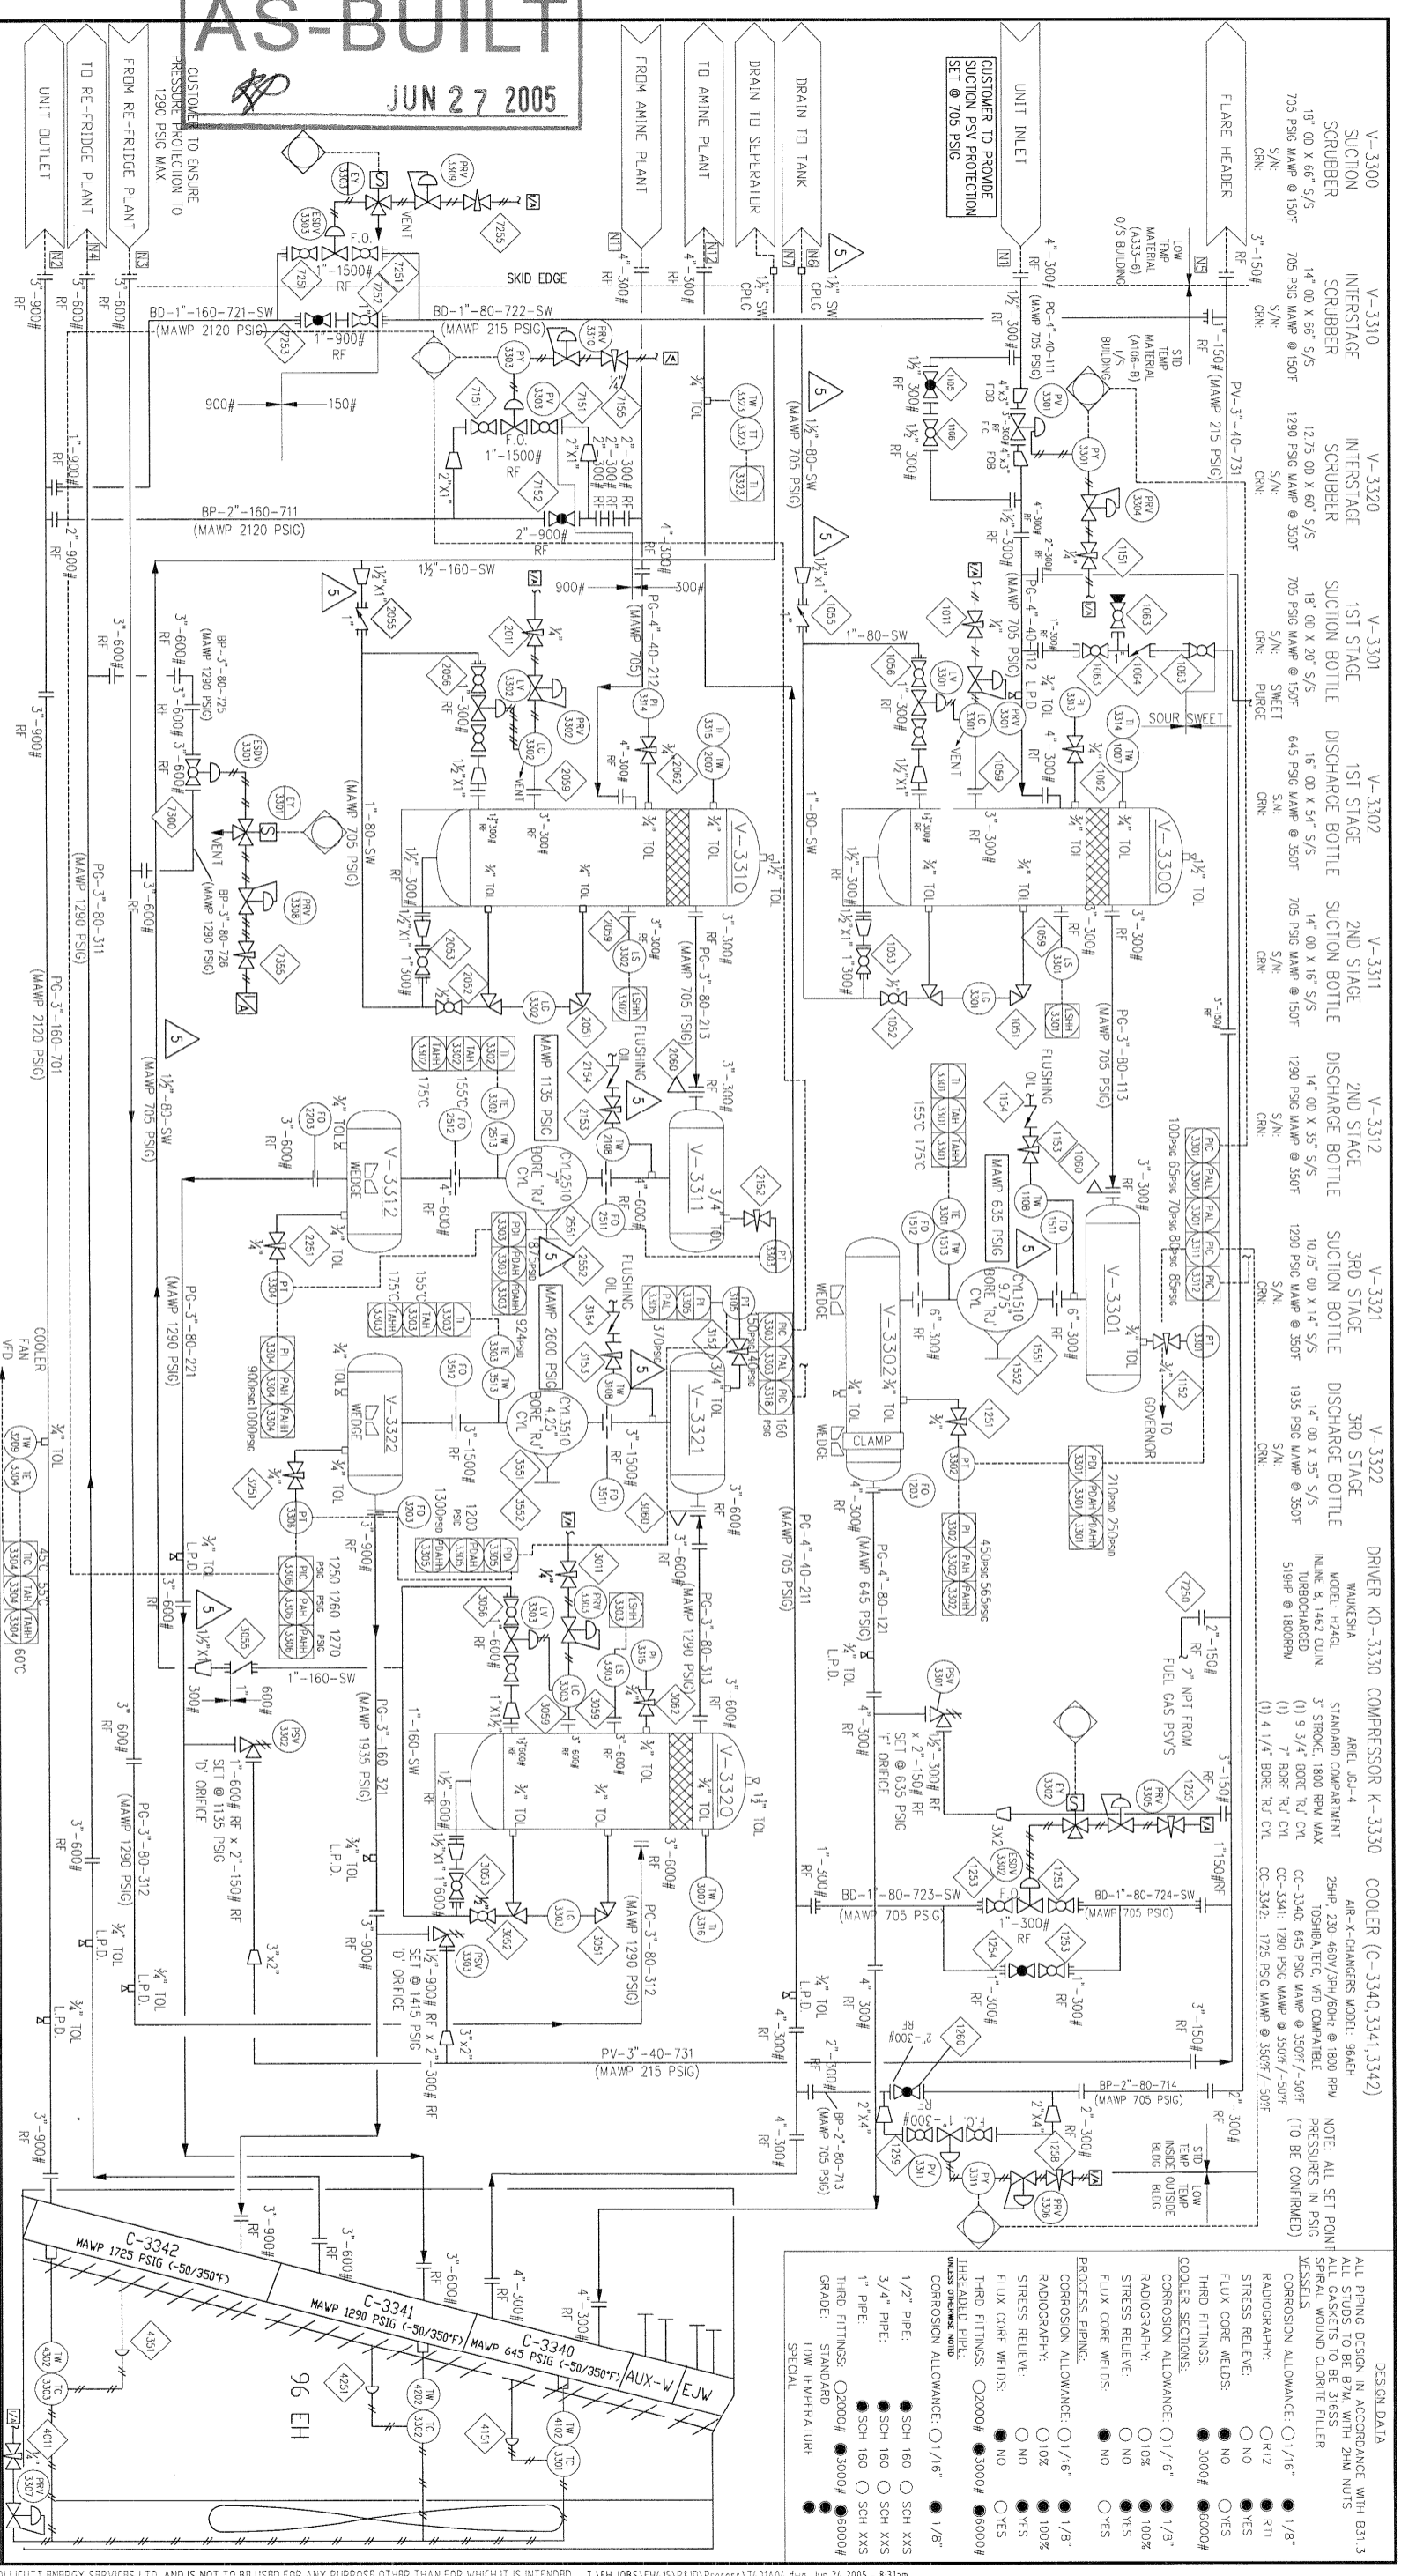

LEGEND

- LOCAL MOUNTED (HUMAN MACHINE INTERFACE)
- ⊖ PANEL MOUNTED (TECHNICAL)

LINE DESIGNATION

- XX-XX-XX-XXX LINE NUMBER
- LINE SCHEDULE
- LINE SIZE
- LINE SERVICE

DESCRIPTION

DRAWINGS

REV

DESCRIPTION

REV

REVISIONS

NO.	DATE	BY	CHK BY	APP BY
1	12.08.04	RS		
2	01.05.05	VCM		
3	01.21.05	RS		
4	02.08.05	VCM		
5	06.24.05	VCM		

CUSTOMER

ENCANA CORPORATION

Q-330

LOCATION: 04-05-041-09 W4M

Collicutt Energy Services Ltd.

CORPORATE OFFICE
7550 EDGAR INDUSTRIAL DRIVE
RED DEER AB CANADA T4P 3R2
PHONE (403) 358-3200
FAX (403) 358-3210

PROCESS PAID

SOUR CLASS

STAGES

COMPRESSOR

DRIVE

COOLER

CONTROL

PAID

REV

DATE

DESIGN DATA

ALL PIPING DESIGN IN ACCORDANCE WITH B31.3
ALL STUDIOS TO BE B7M WITH 2MM NUTS
ALL GASSETS TO BE 316SS
SPIRAL WOUND CLORITE FILTER
VESSELS
CORROSION ALLOWANCE: ○ 1/16" ● 1/8"
RADIOGRAPHY: ○ R12 ● R11
STRESS RELIEVE: ○ NO ● YES
FLUX CORE WELDS: ○ NO ● YES
CORROSION ALLOWANCE: ○ 1/16" ● 1/8"
RADIOGRAPHY: ○ 10% ● 100%
STRESS RELIEVE: ○ NO ● YES
FLUX CORE WELDS: ○ NO ● YES
PROCESS PIPING: ○ NO ● YES
CORROSION ALLOWANCE: ○ 1/16" ● 1/8"
RADIOGRAPHY: ○ 10% ● 100%
STRESS RELIEVE: ○ NO ● YES
FLUX CORE WELDS: ○ NO ● YES
THIRD FITTINGS: ○ 2000# ● 3000# ● 6000#
UNLESS OTHERWISE NOTED
CORROSION ALLOWANCE: ○ 1/16" ● 1/8"
1/2" PIPE: ○ SCH 160 ● SCH XXS
3/4" PIPE: ○ SCH 160 ● SCH XXS
1" PIPE: ○ SCH 160 ● SCH XXS
THIRD FITTINGS: ○ 2000# ● 3000# ● 6000#
GRADE: ○ STANDARD ● LOW TEMPERATURE
SPECIAL